



COASTAL RESOURCES DIVISION
ONE CONSERVATION WAY • BRUNSWICK, GA 31520 • 912.264.7218
COASTALGADNR.ORG

MARK WILLIAMS
COMMISSIONER

DOUG HAYMANS
DIRECTOR

PUBLIC NOTICE

February 15, 2018

Glynn County Public Works Department Maintenance of the Existing Public Crossovers, Modification to an Existing Public Crossover, and Construction of a New Public Crossover St. Simons Island, Glynn County, Georgia

This serves as notification from the Shore Protection Committee and the Georgia Department of Natural Resources of a request from Glynn County Public Works Department for a Shore Protection Act (SPA) permit under Official Code of Georgia (O.C.G.A.) 12-5-230 et seq., to maintain existing crossovers, modify an existing beach crossover at Gould's Inlet, and construct a new crossover at Wyley Street on St. Simons, Glynn County, Georgia.

The applicant currently manages twenty-two existing public beach crossovers. In the event of any future damage or destruction to the existing twenty-two beach crossovers, the applicant proposes to restore and repair the structures as needed. The names and locations of the existing beach crossovers are shown in the attached table, Table 1. These beach crossovers typically have the same standard design. The length and height of the crossover may vary, as needed, in each location. In the event that any of these structures may need to be rebuilt, the replacement will be within the existing footprint of the crossover.

The proposed modification to the Gould's Inlet crossover (Beach Access #40) structure will include permanently extending the crossover 40ft. seaward from which a standard set of wooden stairs will be installed at the seaward terminal end. The stairs will be based on the design of all existing county managed public crossovers. The stairs will be installed at a 45 degree angle and will be attached to two posts, buried for stability. Glynn County Public Works recognizes the shoreline at Gould's Inlet has recently accreted and may erode in the future. In the case that the shoreline changes significantly, Glynn County Public Works will modify the crossover as needed to insure it continues to function as it is intended. The applicant has noted

that the crossover addition could attract a higher number of visitors to the area and parking may become more limited. However, there are no plans to make any modifications to the parking area at this time.

The proposed construction of a new beach crossover at Wyley Street (Beach Access #1) will provide accessibility to the beach at this location. The proposed beach crossover will extend approximately 20ft. over the existing rock revetment and will be 6ft. in width. The crossover will be constructed in a manner typical to the standard design of the other 22 existing crossovers.

It is the responsibility of the applicant to demonstrate that the project is not contrary to the public interest and that no feasible alternative sites exist. In passing upon the application for permit, the permit issuing authority shall consider the public interest which for purposes of this part shall be deemed to be the following considerations: (1) Whether or not unreasonably harmful, increased alteration of the dynamic dune field or submerged lands, or function of the sand-sharing system will be created; (2) Whether or not the granting of a permit and the completion of the applicant's proposal will unreasonably interfere with the conservation of marine life, wildlife, or other resources; and (3) Whether or not the granting of a permit and the completion of the applicant's proposal will unreasonably interfere with reasonable access by and recreational use and enjoyment of public properties impacted by the project.

A detailed public notice with drawings has been distributed and is available by visiting the Department of Natural Resources website: CoastalGaDNR.org under "Marsh & Shore Permits".

Please provide this office with substantive, site-specific comments as to why the proposed work should or should not proceed. Comments and questions concerning this proposed project should be submitted in writing and be submitted by the close of business on March 16, 2018 to Jordan Dodson, Department of Natural Resources, One Conservation Way, Georgia 31520.

Table 1

Wooden Beach Crossovers on Saint Simons Island

Beach Access #	Location
2	Hamilton Street
5	Georgia Street
6	Floyd Street
7	Neptune Park
8	12th Street
9	Postell Ave
10	Demere Road
11	11th Street
12	10th Street
13	9th Street
14	7th Street
16	5th Street
17	3rd Street
18	2nd Street
19	1st Street
20	Myrtle Street
22	Neptune Road
24	Massengale Park
25	Driftwood Drive
26	Olive Way
27	Coast Guard Station
40	Goulds Inlet

RECEIVED
 JUL 13 2017
 GA DNR



GLYNN COUNTY PUBLIC WORKS
 4145 NORWICH STREET - BRUNSWICK, GEORGIA 31520
 PHONE: (912) 554-7746 / FAX: (912) 558-1549
 WWW.GLYNNCOUNTY.ORG

REVISIONS	DATE



WYLEY STREET
 BEACH CROSSOVER
 NEW CONSTRUCTION
 GLYNN COUNTY, GEORGIA

DATE: 10 JULY 2017
 SCALE: 1:20
 DESIGN BY: TMV
 DRAWN BY: TMV
 REVIEWED BY:

The proposed project area has a zoning designation that permits park and recreation in the area. The proposed project does not violate Glynn County's Zoning Ordinance.

Pamela Thompson 7.10.17
 Pamela Thompson
 Director of Community Development

I HEREBY CERTIFY: THAT THIS SURVEY WAS PREPARED IN CONFORMITY WITH THE TECHNICAL STANDARDS FOR PROPERTY SURVEYS IN GEORGIA AS SET FORTH IN CHAPTER 180-7 OF THE BOARD RULES OF THE GEORGIA BOARD OF REGISTRATION FOR PROFESSIONAL ENGINEERS AND LAND SURVEYORS AND AS SET FORTH IN THE GEORGIA PLAT ACT O.C.G.A. 15-6-67.

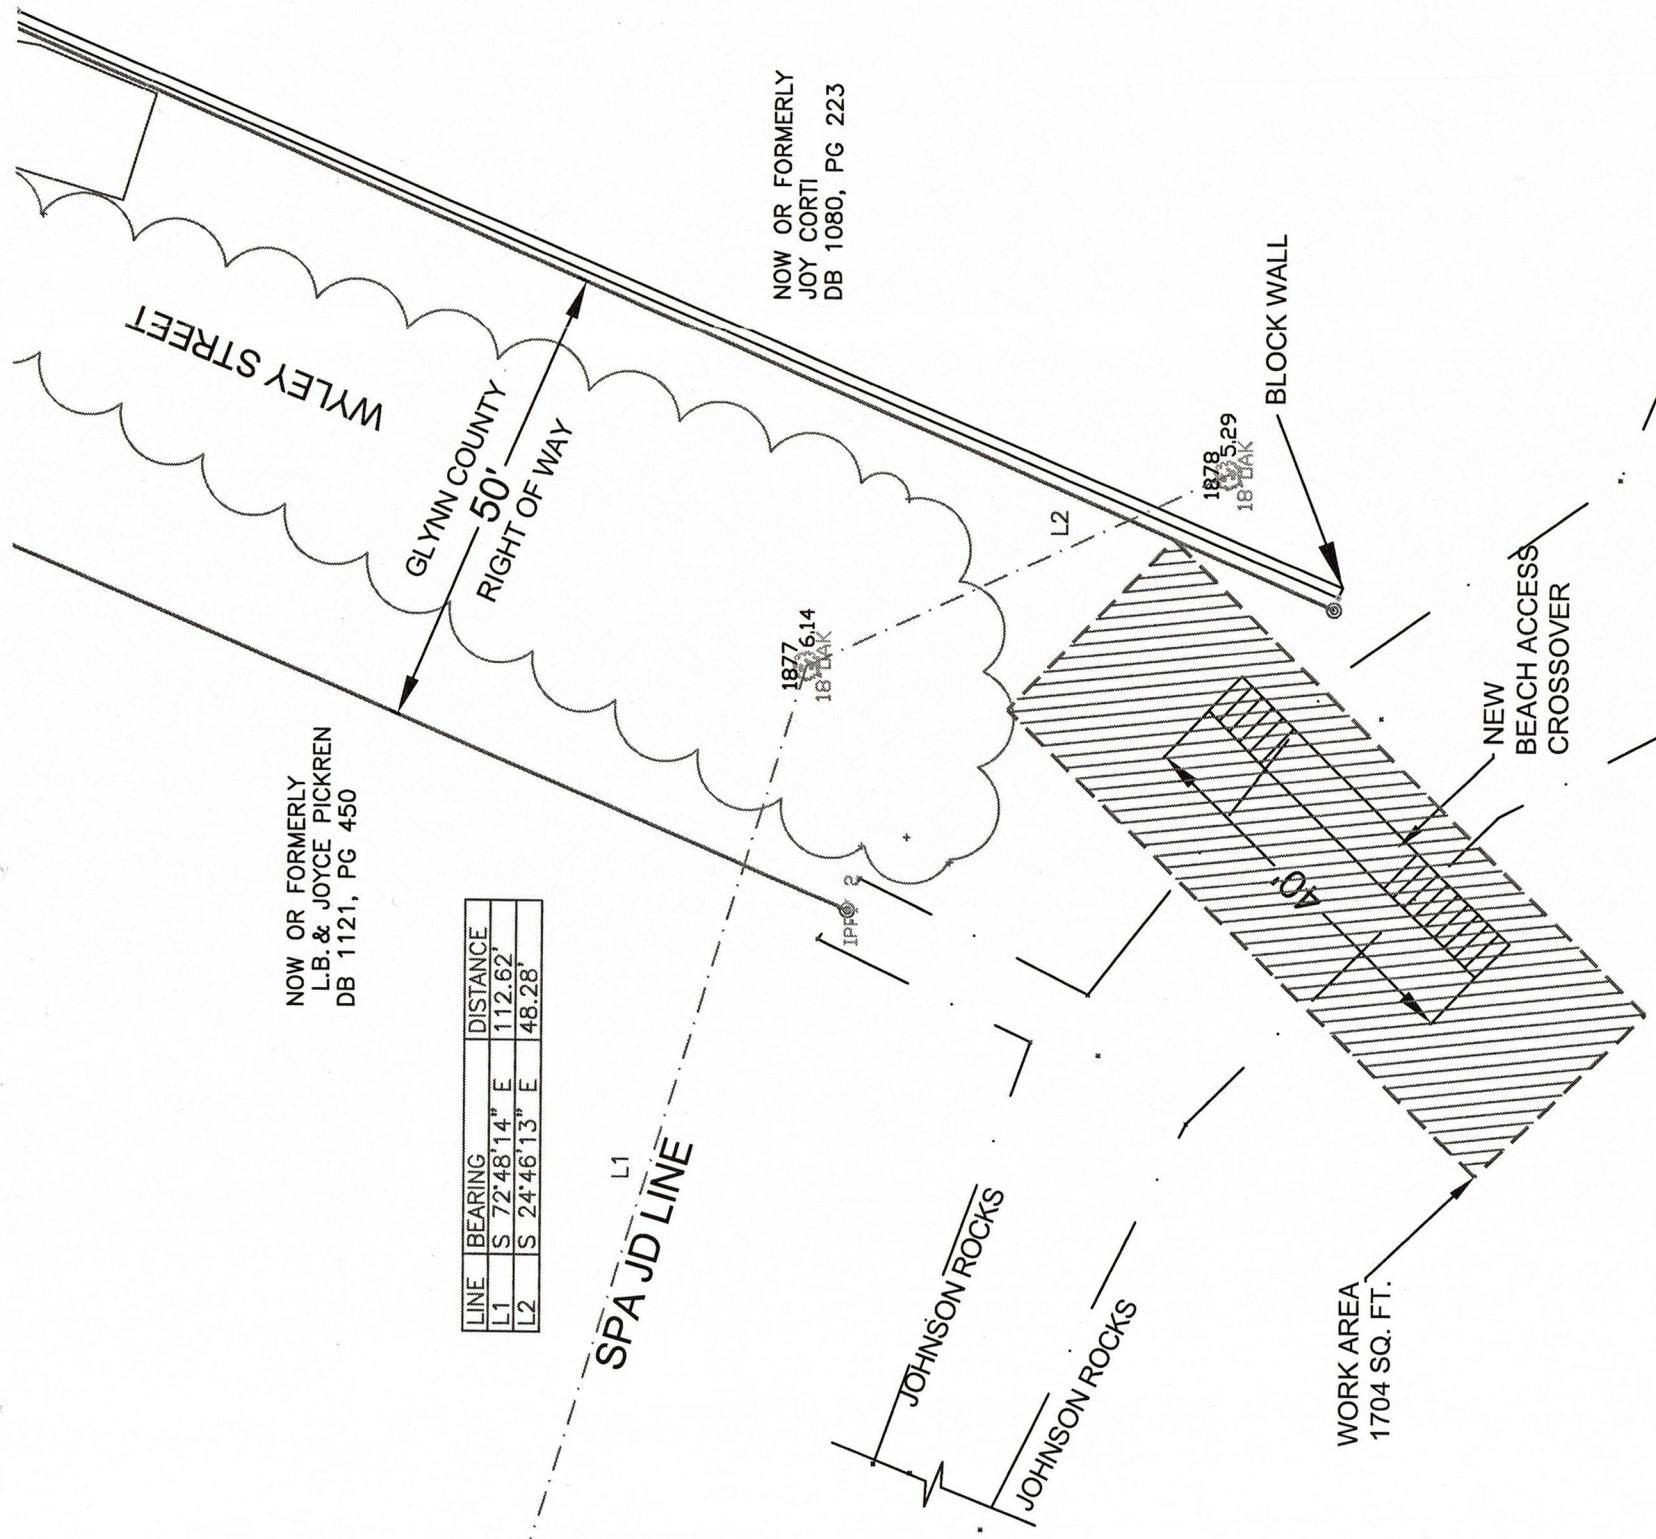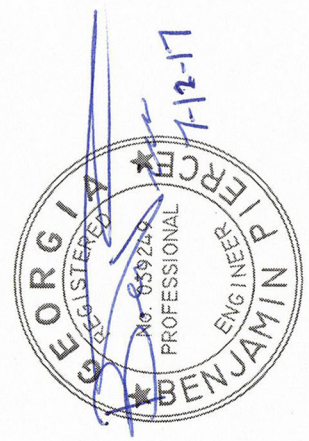


RECEIVED
 JUL 13 2017
 GA DNR

SITE PLAN
 WYLEY STREET


BEACH CROSSOVER

GLYNN COUNTY
PUBLIC WORKS

DRAWING N.T.S.

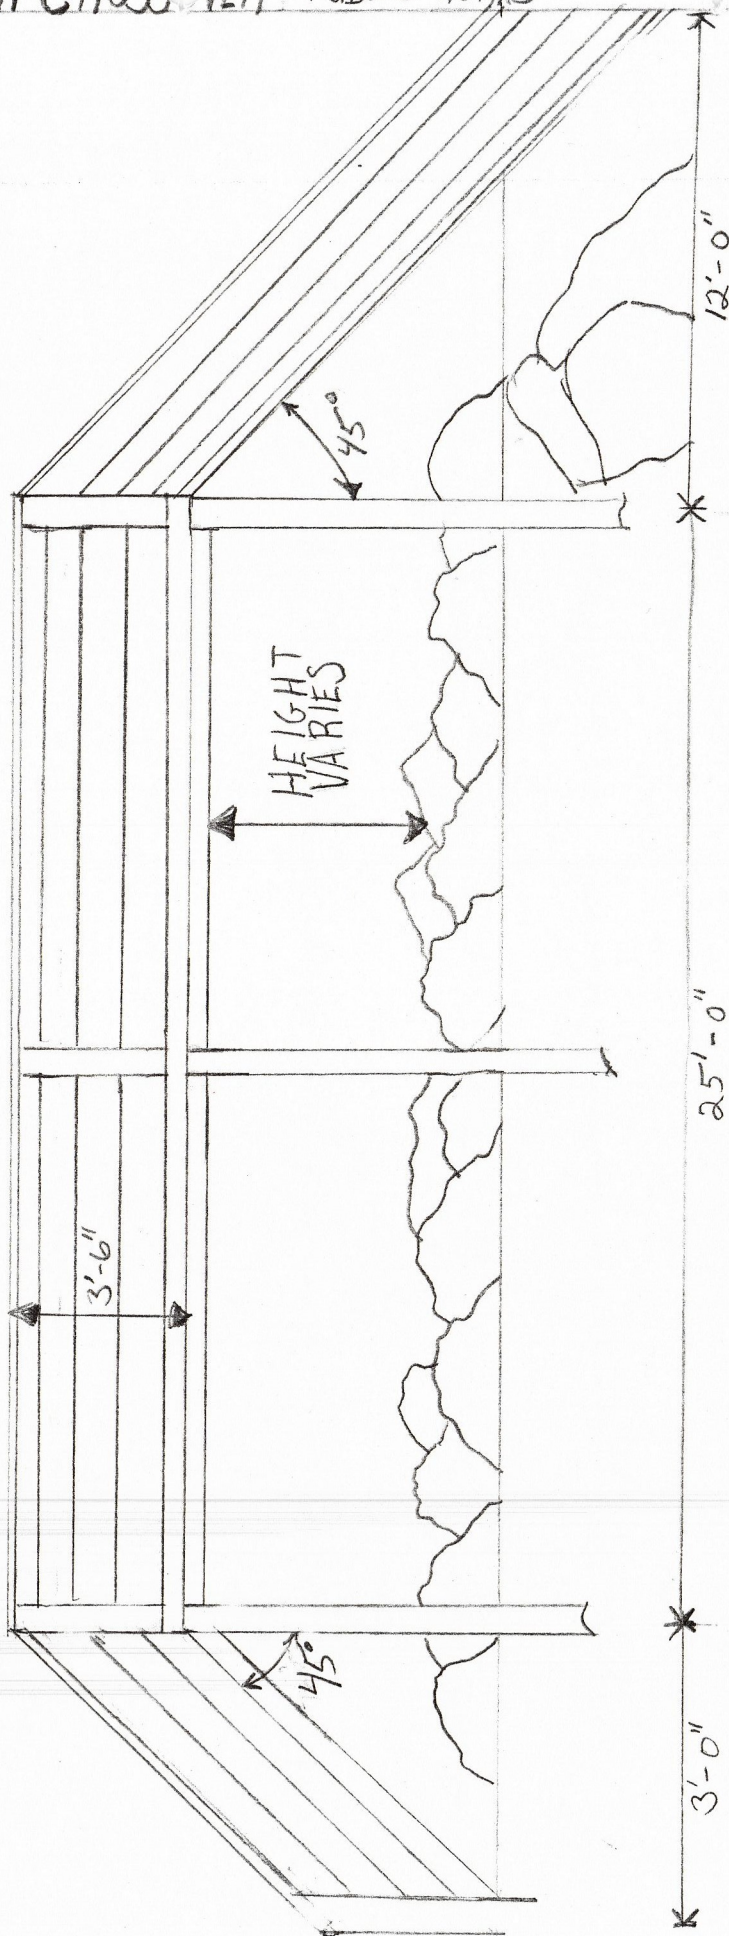

RECEIVED
JUL 13 2017
GA DNR

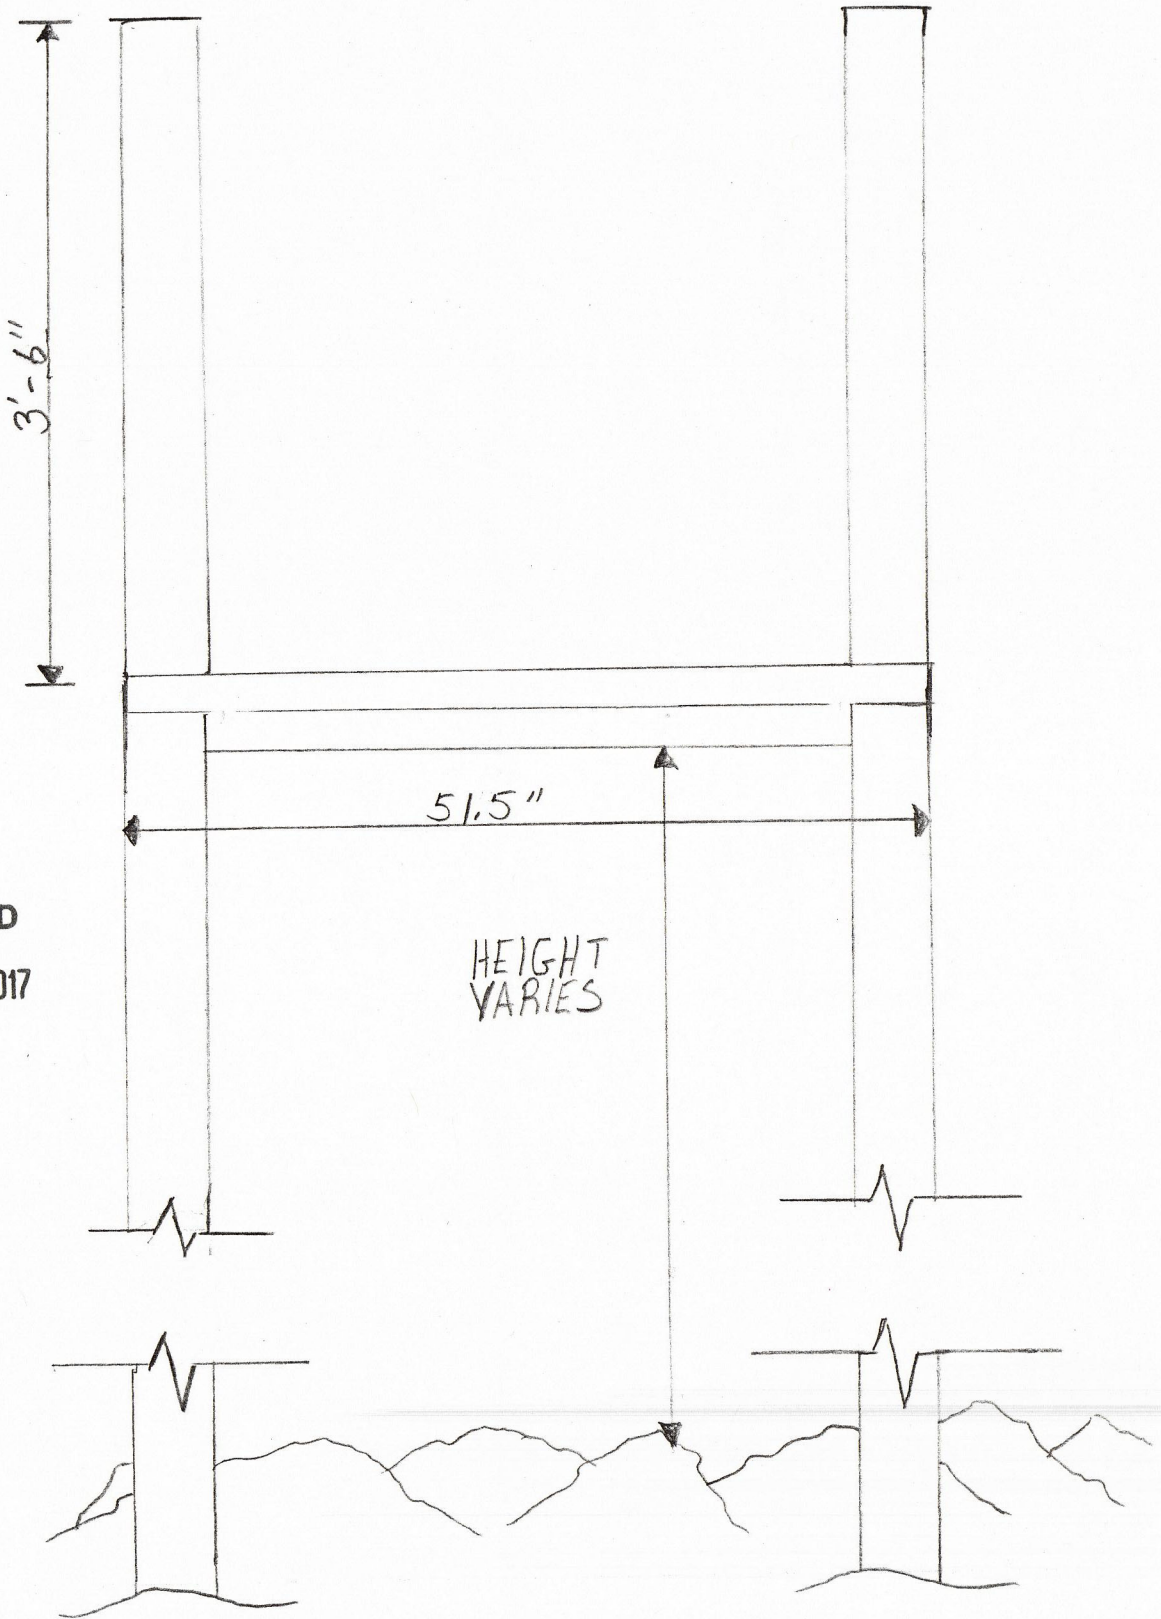

RECEIVED
JUL 13 2017
GA DNR

SECTION VIEW




PREPARED BY:
 GLYNN COUNTY PUBLIC WORKS
 4165 NORWICH STREET - BRUNSWICK, GEORGIA 31520
 WWW.GLYNNCOUNTY.ORG
 PHONE: (912) 554-7746 / FAX: (988) 558-1549


DATE	02/01/18
REVISIONS	CHANGED EXTENSION FROM 20' TO 40'

GLYNN COUNTY, GEORGIA
 GOULD'S INLET
 CROSSOVER ADDITION


DATE:	12 APR 17
SCALE:	VARIABLES
DESIGN BY:	TMM
DRAWN BY:	TMM
REVIEWED BY:	

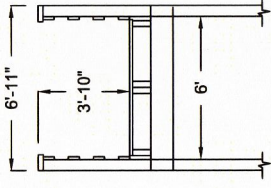

SECTION 'A-A'
 GOULD'S INLET BEACH CROSSOVER
 SCALE 1:5

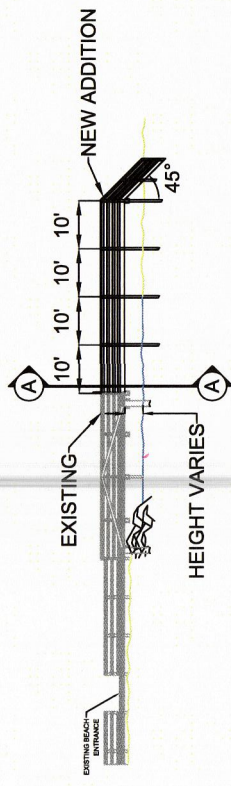

PROFILE VIEW
 GOULD'S BEACH CROSSOVER
 SCALE 1:25

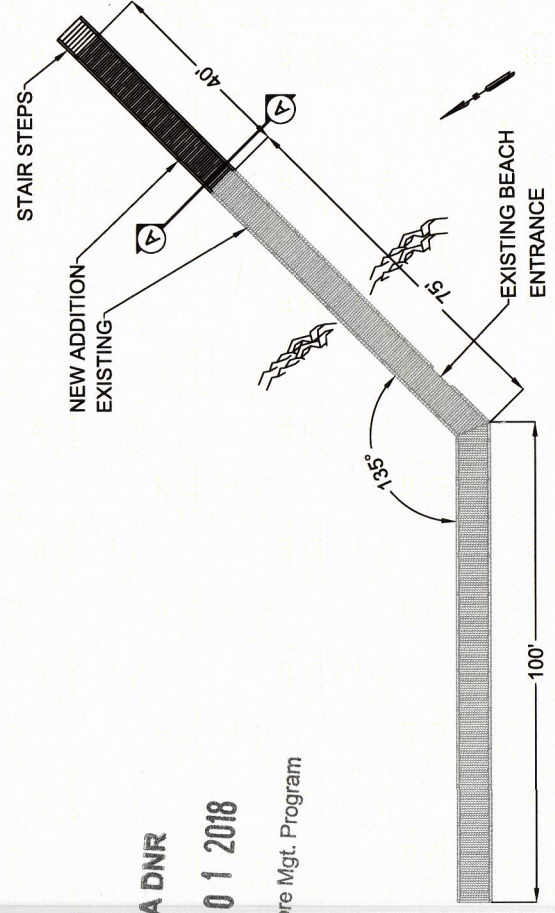

PLAN VIEW
 GOULD'S INLET BEACH CROSSOVER
 SCALE 1:25

GA DNR
 FEB 01 2018
 Marsh & Shore Mgt. Program



PREPARED BY:
 GLYNN COUNTY PUBLIC WORKS
 4145 NORWICH STREET - BRUNSWICK, GEORGIA 31520
 PHONE: (912) 554-7746 / FAX: (912) 558-1549
 WWW.GLYNNCOUNTY.ORG

REVISIONS	DATE
CHANGED EXTENSION FROM 20' TO 40'	02/01/18


GLYNN COUNTY, GEORGIA
 GOULD'S INLET
 CROSSOVER ADDITION
 SITE PLAN

DATE: 12 APR 17
SCALE: 1:50
DESIGN BY: TM
DRAWN BY: TM
REVIEWED BY:

GA DNR

FEB 01 2018

Marsh & Shore Mgt. Program

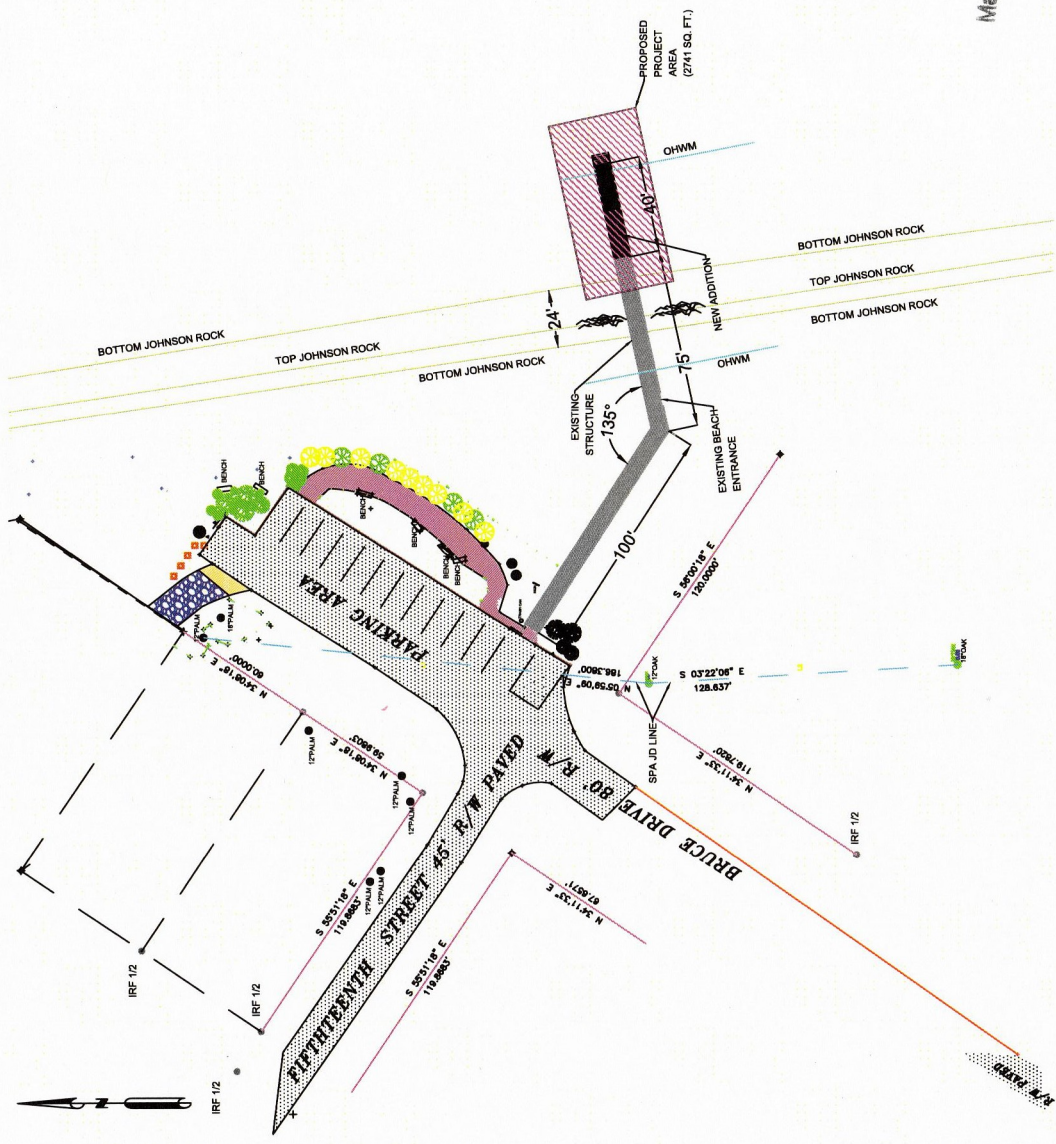

SITE PLAN
 GOULD'S INLET